


USER MANUAL FOR SUBSEA COMPENSATORS 0,03-3 LITER

Document title : *UMA-6231-XXX Subsea Compensators*
IKM Subsea AS ref. : *P6231 / IKM-1003730*
Customer ref. : *Not applicable*




IKM Subsea AS

Rev.	Date	Reason For Issue	Prepared	Checked	Approved
01	31.01.13	Issued for review	JHR	EN	KG
02	13.06.16	Update	KF	RK	KF
03	15.11.24	Update + Added IKM-1003730	TO	OG	AL

BTE.12-26 User Manual			Page 2 of 21	
Dok.ID:	010984	Issue date:	2014.12.29	
Approved date:	2015.02.13	Rev.no:	003	
Author:	Gabrielsen Trine (Technique)	Owner:	IKM Administrator	
Approved by:	Reinsnos Jostein (Technique)	Company:	IKM Technique AS	

USER MANUAL FOR SUBSEA COMPENSATORS 0,03-3 LITER.....	1
1 GENERAL INFORMATION	3
1.1 Abbreviations.....	4
1.2 References	5
2 TECHNICAL SPECIFICATION.....	6
3 SAFETY	7
3.1 General – Operations	7
3.2 General – Hydraulic.....	7
3.3 General – Mechanical	8
4 INTALLATION	9
5 MAINTENANCE	10
6 SPARE PART LIST	12
7 REVISION CHANGES	13
8 CONTACT INFORMATION	13
9 APPENDIX	14

BTE.12-26 User Manual		Page 3 of 21	
Dok.ID:	010984	Issue date:	2014.12.29
Approved date:	2015.02.13	Rev.no:	003
Author:	Gabrielsen Trine (Technique)	Owner:	IKM Administrator
Approved by:	Reinsnos Jostein (Technique)	Company:	IKM Technique AS



1 GENERAL INFORMATION


The purpose of this manual is to guide and safeguard users of IKM Subsea range of compensators. Models covered by this manual are 0.03 liter, 0,25 liter, 1.0 liter, 2.0 liter and 3.0 liter types. Please note that all IKM Subsea compensators are designed, tested and used for compensation of oil filled cavities on temporary subsea equipment as ROV's and ROT's of various types and models. The purposes of a compensator by these means are to provide a given volume and pressure for oil filled subsea equipment. Variants of the different models will occur. Thus, will the main and important issues on safety, parts and use be the same.



WARNING!!


All spring-loaded compensators are under load, often high spring forces. Injury and damage to personnel and equipment can occur if work (dismantling) of the compensator is performed outside the procedure described in this manual. Fluid inside a compensator is normally under pressure. Take care to release pressure before opening fittings.

BTE.12-26 User Manual			Page 4 of 21
Dok.ID:	010984	Issue date:	2014.12.29
Approved date:	2015.02.13	Rev.no:	003
Author:	Gabrielsen Trine (Technique)	Owner:	IKM Administrator
Approved by:	Reinsnos Jostein (Technique)	Company:	IKM Technique AS



1.1 Abbreviations


HPU	Hydraulic Power Unit
ROV	Remotely Operated Vehicle
kg	Kilogram
mm	Millimeter
BSP	British standard pipe
JIC	Joint industry council
CCM	Cubic centimeter
LPM	Liter per minute
Nm	Newton meter
CCW	Counterclockwise
ml	Milliliter

BTE.12-26 User Manual			Page 5 of 21	
Dok.ID:	010984	Issue date:	2014.12.29	
Approved date:	2015.02.13	Rev.no:	003	
Author:	Gabrielsen Trine (Technique)	Owner:	IKM Administrator	
Approved by:	Reinsnos Jostein (Technique)	Company:	IKM Technique AS	

1.2 References

Doc nr	Description	Rev.	Issued	Can be found
6231-XXX	Drawings of respective compensators			Appendix A

BTE.12-26 User Manual			Page 6 of 21
Dok.ID:	010984	Issue date:	2014.12.29
Approved date:	2015.02.13	Rev.no:	003
Author:	Gabrielsen Trine (Technique)	Owner:	IKM Administrator
Approved by:	Reinsnos Jostein (Technique)	Company:	IKM Technique AS




2 TECHNICAL SPECIFICATION

The Subsea Compensators main components are the frame/housing, fluid reservoir (bellow) and spring. Material used is POM-C, stainless steel and rubber. Empty compensator sensor (electrical) is optional for some compensators.

Recommended direction for installation is vertical to enable bleeding the compensator for air. The 2L model must however be installed horizontally for better air-bleeding.

Capacity	Part Number	Dimensions	Weight	Fluid	Pressure
30 ml	6231-010	Ø 58 mm Max length 114 mm Min length 81 mm	In air: 0,13 kg In water: 0,04 kg	Mineral oil	10%: 0,05 bar 90%: 0,8 bar
0,25 liter	IKM-1003730	Ø 130 mm Max length 207 mm Min length 152 mm	In air: 2 kg In water: 1,22 kg	Mineral oil	10%: 0,08 bar 90%: 0,23 bar
1 liter	6231-008	Ø 160mm Max length 398 mm Min length 297 mm	In air: 3,74 kg In water: 2,03 kg	Mineral oil	10%: 0,1 bar 90%: 0,6 bar
2 liter	6231-003	Ø 160mm Max length 781 mm Min length 579 mm	In air: 6,62 kg In water: 3,48 kg	Mineral oil	10%: 0,1 bar 90%: 0,6 bar
3 liter	6231-000	Ø 246mm Max length 462 mm Min length 332 mm	In air: 9,44 kg In water: 4,74 kg	Mineral oil	10%: 0,2 bar 90%: 0,4 bar

BTE.12-26 User Manual			Page 7 of 21
Dok.ID:	010984	Issue date:	2014.12.29
Approved date:	2015.02.13	Rev.no:	003
Author:	Gabrielsen Trine (Technique)	Owner:	IKM Administrator
Approved by:	Reinsnos Jostein (Technique)	Company:	IKM Technique AS



3 SAFETY

3.1 General – Operations

Only authorised people and qualified personnel should work on the system and take suitable precautions to prevent any potential injuries. Always adhere to authorised working practices and use the correct tools for the job. To facilitate this, make sure that these are available before commencing the test.

Ensure that the working area is kept clear and uncluttered.

3.2 General – Hydraulic

Do not work on pressurised systems. Hydraulic systems contain a large amount of stored energy when pressurised, therefore the system (including any accumulators) should be de-pressurised, and the power pack switched off, prior to working on the system. Exceptions to this would be system adjustments to components requiring the presence of pressure and/or flow.

Any personnel authorised to work on the system must have a complete understanding of the operation of the hydraulic system, so that they will be aware of any system liable to remain pressurised or hazardous in any other way. Ensure that all personnel are clear of any mechanical/hydraulic system likely to move if pressure to system actuators is released or applied.

Do not attempt to tighten any leaking fittings whilst under pressure. A hose/fitting rupture could result, leading to injury from flying components and/or oil jets.


Regularly inspect fittings and pipework for mechanical damage. If any such damage is found, the item must be repaired or replaced as necessary before pressure is applied to the system. Do not allow damaged fittings to remain in service.

Take care when inspecting, commissioning, repairing or maintaining the system to avoid jets of oil issuing from open orifices; pipe ends etc. if pressure is applied. Particular care should be taken to protect the eyes.

Hydraulic components may be heavy and slippery when covered in oil. Ensure that adequate protective clothing and footwear is used.

Any moving component should be treated with caution when the system is pressurised during operation, and especially during on-deck testing and repair. Keep clear of all moving components and take all necessary precautions to avoid injury when working on these systems by preventing movement of any components likely to cause injury.

BTE.12-26 User Manual			Page 8 of 21
Dok.ID:	010984	Issue date:	2014.12.29
Approved date:	2015.02.13	Rev.no:	003
Author:	Gabrielsen Trine (Technique)	Owner:	IKM Administrator
Approved by:	Reinsnos Jostein (Technique)	Company:	IKM Technique AS



3.3 General – Mechanical

Beware of and keep clear of all moving components. Do not work on the system whilst power is applied, or if there is any potential for components to move.


Ensure that all load bearing components are adequately and regularly inspected. If damage is found the component must be repaired/replaced as necessary. Do not allow damaged components to remain in service.

Always ensure that items are correctly and adequately supported before removal, and that authorised lifting equipment and procedures are used.

Note: trying to lift heavy components in an awkward position by hand without the assistance of correct lifting equipment, or lifting any component without adopting the correct stance, can lead to serious injury.

Ensure that when working within or underneath the machine that your presence is known to your supervisor. If working underneath the machine, always ensure that there are no loose or unsupported assemblies, components or tools above.


BTE.12-26 User Manual			Page 9 of 21
Dok.ID:	010984	Issue date:	2014.12.29
Approved date:	2015.02.13	Rev.no:	003
Author:	Gabrielsen Trine (Technique)	Owner:	IKM Administrator
Approved by:	Reinsnos Jostein (Technique)	Company:	IKM Technique AS



4 INSTALLATION

- The compensators shall in general be mounted vertical to allow for bleeding out air.
- The 2L compensator must be mounted horizontally with designated bleed-port up.
- Make sure to have enough free space around the compensator so the indicator shaft can move freely.
- Fill up the compensator $\frac{1}{4}$ to $\frac{3}{4}$ full and bleed all air out of the compensator and circuit to be compensated. Start bleeding process at the compensator itself and continue to next logic bleed point of the circuit.
- The filling-level in the compensator during operations/use depends a lot on what it is connected to. Is there a great change in volume (ex. Cylinder), is it a big variety in the heat of the fluid (ex. Motor, pressure) or is it simply a fluid filled cavity. All these points must be taken under consideration before setting a fluid level.

BTE.12-26 User Manual			Page 10 of 21
Dok.ID:	010984	Issue date:	2014.12.29
Approved date:	2015.02.13	Rev.no:	003
Author:	Gabrielsen Trine (Technique)	Owner:	IKM Administrator
Approved by:	Reinsnos Jostein (Technique)	Company:	IKM Technique AS



5 MAINTENANCE

Dismantling of compensators

30 ml type, ref GA dwg 6231-010

1. Not serviceable. Replace unit if failure.

0.25 liter type, ref GA dwg IKM-1003730

1. Make sure all internal pressure is released from compensator
2. Loosen 8pc cylinder head cap screws (pos. 6).
3. Make sure the spring pressure is low and stable.
4. Unscrew 8pc cylinder head cap screws (pos. 6).
5. Retract bellow (pos. 7) and piston rod (pos. 4) from bottle (pos. 1).
6. The compensator is now separated and bellow available for close inspection.
7. In case of replacing bellow, no more dismantling is required.
8. 8.Install new bellow if needed and mount together compensator in the opposite order as described above.


Note: Be aware of oil spill, use necessary protective equipment.

1 liter type, ref GA dwg 6231-008

1. Make sure all internal pressure is released from compensator
2. Loosen 8 off M8 nuts & bolts, (item 14 to 16)
3. Make sure the spring pressure is low and stable
4. Unscrew 8 off M8 nuts & bolts. (item 14 to 16)
5. Retract piston, (item 1)
6. Retract bellow and spring assy, (item 12 & 13)
7. Remove bellow for close visual inspection by unscrew 3 off M4 screws, (item 3)
8. Replace bellow as required.
9. Clean all parts properly and remove all traces of sand & silt

Note: Be aware of oil spill, use necessary protective equipment.

BTE.12-26 User Manual			Page 11 of 21
Dok.ID:	010984	Issue date:	2014.12.29
Approved date:	2015.02.13	Rev.no:	003
Author:	Gabrielsen Trine (Technique)	Owner:	IKM Administrator
Approved by:	Reinsnos Jostein (Technique)	Company:	IKM Technique AS



2 liter type, ref GA dwg 6231-003
(Two of 1 liter compensator)

3 liter type, ref GA dwg 6231-000

1. Make sure all internal pressure is released from compensator
2. Loosen 8 off M8 nuts & bolts, (item 13 to 15)
3. Make sure the spring pressure is low and stable
4. Unscrew 8 off M8 nuts & bolts. (item 13 to 15)
5. Retract compensator piston with bellow, (item 12)
6. Retract spring
7. Remove bellow for close visual inspection by unscrewing 3 off M5 screws, (item 6)
8. Replace bellow as required.
9. Clean all parts properly and remove all traces of sand & silt


Note: Be aware of oil spill, use necessary protective equipment.

Assembly of compensators

All procedures above to be reversed

- Clean the compensators with fresh water after use and apply a light layer with WD40 or similar.
- Check for any irregularities.


BTE.12-26 User Manual			Page 12 of 21
Dok.ID:	010984	Issue date:	2014.12.29
Approved date:	2015.02.13	Rev.no:	003
Author:	Gabrielsen Trine (Technique)	Owner:	IKM Administrator
Approved by:	Reinsnos Jostein (Technique)	Company:	IKM Technique AS



6 SPARE PART LIST

- Spring
- Bellow
- Sensor/Cable if applicable
- Nuts and bolts

BTE.12-26 User Manual			Page 13 of 21
Dok.ID:	010984	Issue date:	2014.12.29
Approved date:	2015.02.13	Rev.no:	003
Author:	Gabrielsen Trine (Technique)	Owner:	IKM Administrator
Approved by:	Reinsnos Jostein (Technique)	Company:	IKM Technique AS



7 REVISION CHANGES

Revision	Procedure change	Author
01	<i>Original version</i>	JHR
02	<i>Update</i>	KF
03	<i>Update</i>	TO


8 CONTACT INFORMATION

All enquiries relating to the equipment should be addressed to:

IKM Subsea AS
 Nordlysveien 7,
 N-4340 Bryne
 Norway

Phone, 24/7 : +47 962 00 210 / Or IKM Subsea's Sales representative


Mail : Subseatools@ikm.no / Or IKM Subsea's Sales representative

BTE.12-26 User Manual			Page 14 of 21	
Dok.ID:	010984	Issue date:	2014.12.29	
Approved date:	2015.02.13	Rev.no:	003	
Author:	Gabrielsen Trine (Technique)	Owner:	IKM Administrator	
Approved by:	Reinsnos Jostein (Technique)	Company:	IKM Technique AS	


9 APPENDIX

	Doc number	Description	Rev
<i>Appendix A</i>	6231-XXX	<i>Drawings of Compensators</i>	
<i>Appendix B</i>			

6231-010 30ml Compensator

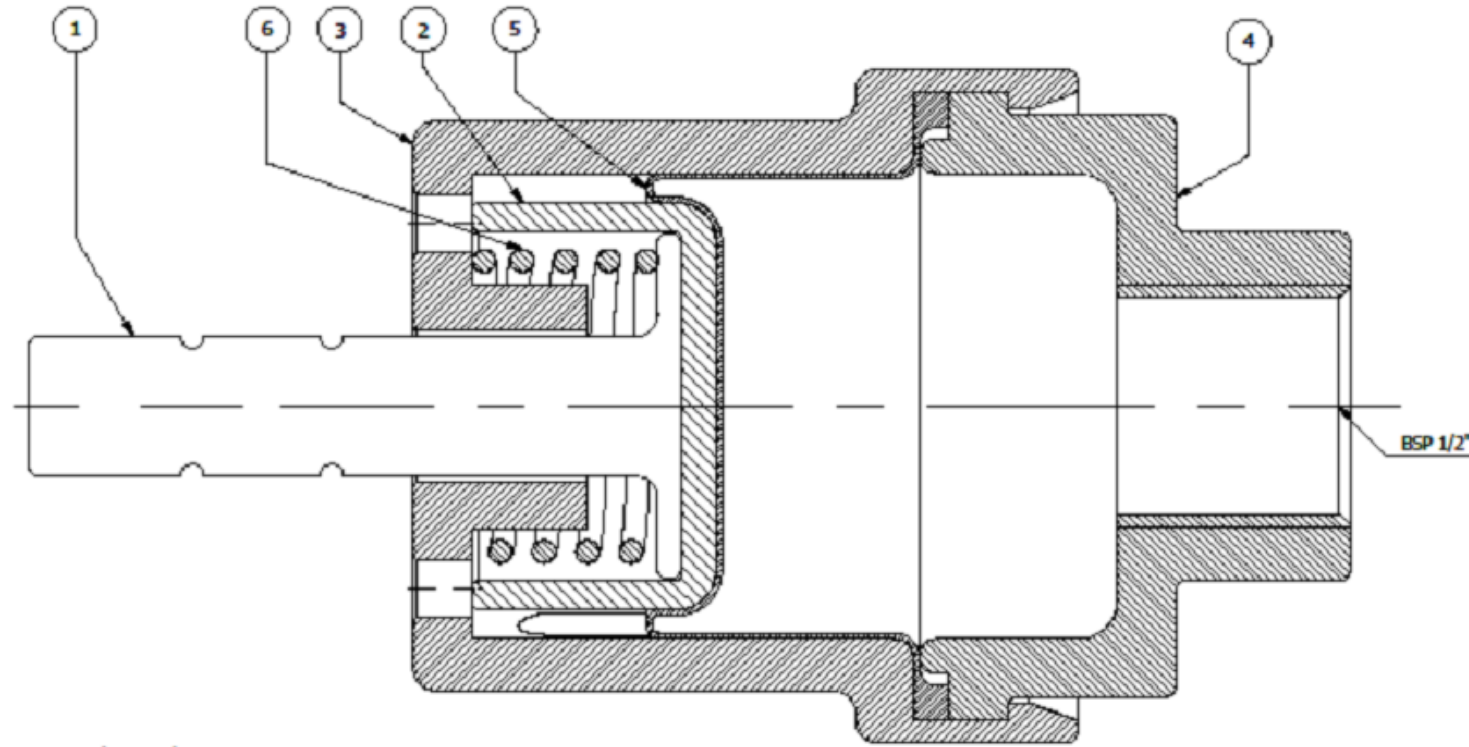


VIEW1 (2 : 1)

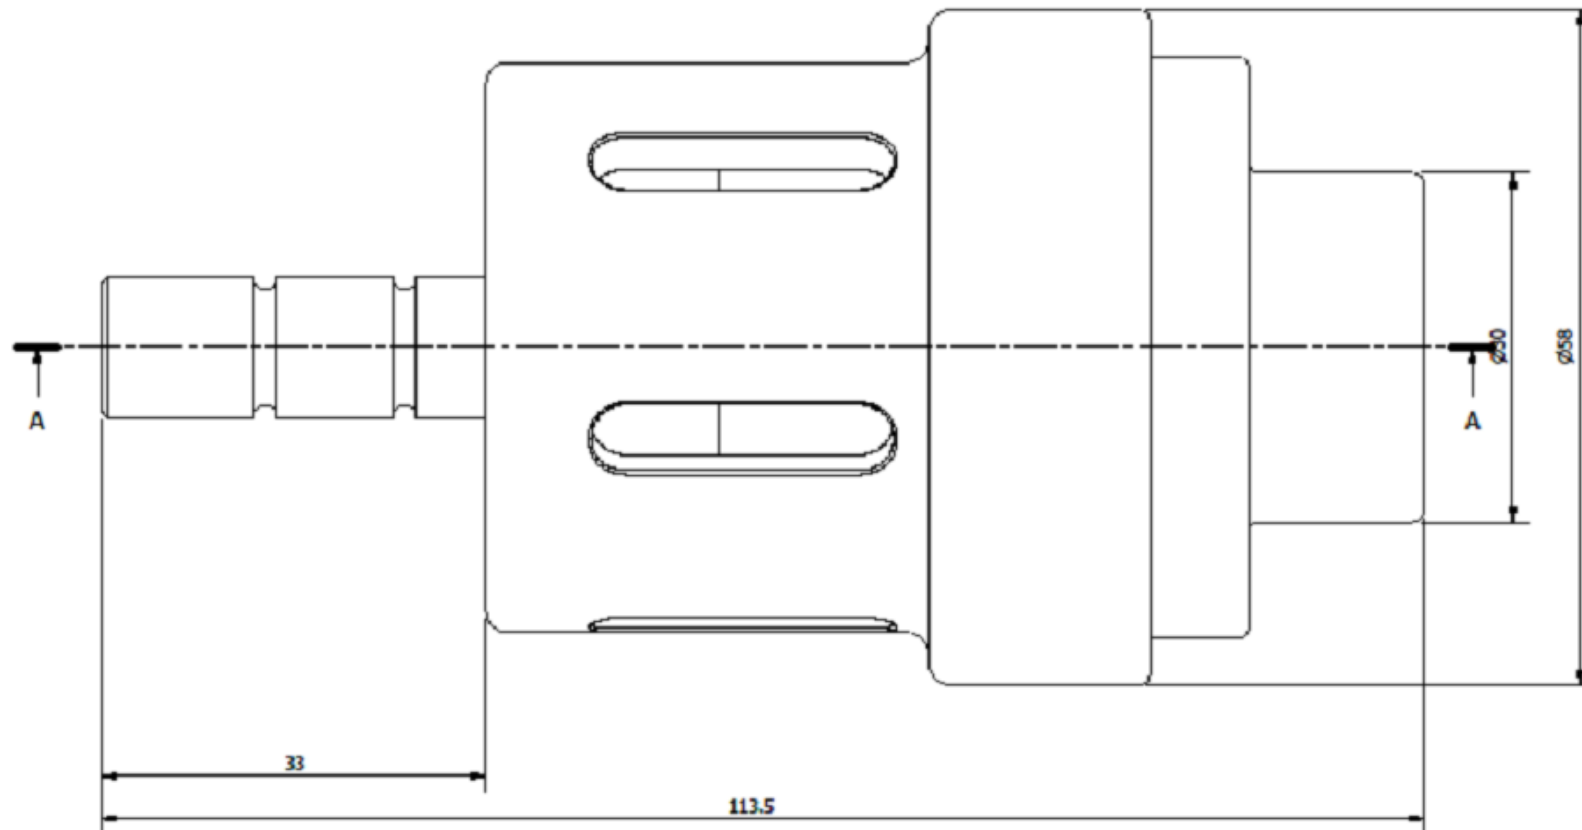

PARTS LIST					
ITEM	QTY	PART NUMBER	MATERIAL	WEIGHT	DESCRIPTION
1	1	6231-153	POM-H (natural / white)	0.01 kg	Piston Shaft
2	1	6231-152	POM-H (black)	0.01 kg	Piston
3	1	6231-150	POM-H (black)	0.05 kg	Housing
4	1	6231-151	POM-H (black)	0.04 kg	Housing
5	1	6231-154	Rubber	0 kg	Bellows
6	1	6231-155	Stainless Spring Steel	0.01 kg	Coil Spring



VIEW3 (1 : 1)

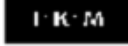
01	15.03.2013	For Construction	POD	EN	POD
REV	DATE	DESCRIPTION	BY	CHKD	APPD
WEIGHT:					
IN AIR:	0,128 kg				
IN WATER:	0,042 kg				
UNLESS OTHERWISE SPECIFIED:		 IKM TECHNIQUE AS Tomeroseveien 12, 4315 SANDNES Tel.: 51 80 05 20 E-mail: ikmtechnique@ikm.no Web: www.ikm.no			
ALL DIMENSIONS ARE IN MILLIMETRES					
TOLERANCES:		THIS DOCUMENT CONTAINS PROPRIETARY INFORMATION WHICH IS THE PROPERTY OF IKM TECHNIQUE AS. NONE OF THE INFORMATION CONTAINED HEREIN MAY BE DISCLOSED, REPRODUCED, DISTRIBUTED OR USED WITHOUT WRITTEN CONSENT FROM IKM TECHNIQUE AS.			
LINEAR: ISO 2768-1 m		PROJECT TITLE: P6231			
ANGULAR: ISO 2768-1 m		DRAWING TITLE: Mini Compensator - 30 mm			
EDGES: ISO 2768-1 m		SHEET SIZE: A3 SHEET NO: 1 OF 1 SCALE			
REMOVE ALL BURRS BREAK ALL SHARP EDGES		DRAWING NO: 6231-010 LATEST REV.: 01			
FIRST ANGLE PROJECTION					

Dok.ID:	010984	Issue date:	2014.12.29
Approved date:	2015.02.13	Rev.no:	003
Author:	Gabrielsen Trine (Technique)	Owner:	IKM Administrator
Approved by:	Reinsnos Jostein (Technique)	Company:	IKM Technique AS




IKM-1003730 0,25 liter Compensator


POS	QTY	TITLE*	IKM PART NUMBER	MATERIAL	TOT. MASS	TOT. VOLUME	COMMENTS
1	1	COMPENSATOR BOTTLE 0,25L	IKM-1003724	PCM-C (Polyoxymethylen)	0,537 kg	0,381 l	
2	1	COMPENSATOR IWASHER 0,25L	IKM-1003725	SS A191 316L	0,042 kg	0,005 l	
3	1	COMPENSATOR PISTON 0,25L	IKM-1003726	PCM-C (Polyoxymethylen)	0,137 kg	0,067 l	
4	1	COMPENSATOR PISTON ROD 0,25L	IKM-1003727	PCM-C (Polyoxymethylen)	0,015 kg	0,011 l	
5	1	COMPENSATOR TOP COVER 0,25L	IKM-1003728	Titanium	1,1 kg	0,244 l	
6	8	CYLINDER HEAD CAP SCREW - DIN 912 - M6 x 25	IKM-7000501	A4	0,071 kg	0,009 l	
7	1	COMPENSATOR BELLOWS 0,25L	IKM-1003723	NBR SHORE 70 A	0,063 kg	0,023 l	
8	1	ROV COMPENSATOR SYSTEM 0,25L Compress Spring	IKM-1003733	Stainless Steel	0,031 kg	0,004 l	LESJØFORS

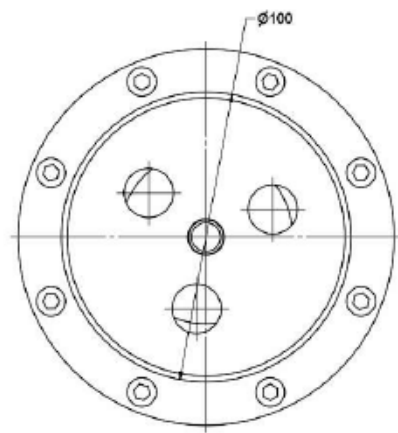


VIEW2 (1:2)

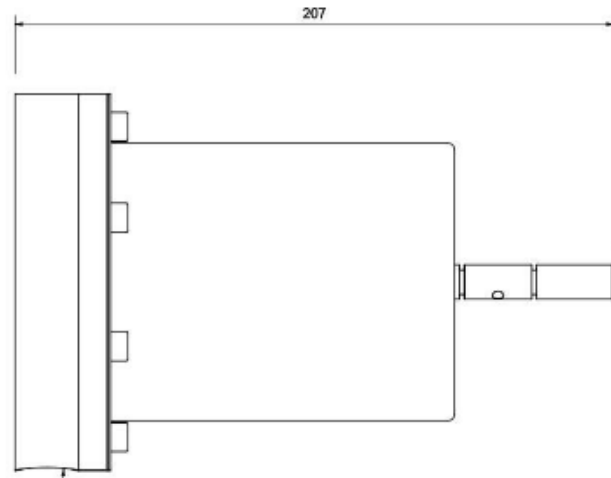


VIEW1 (1:2)

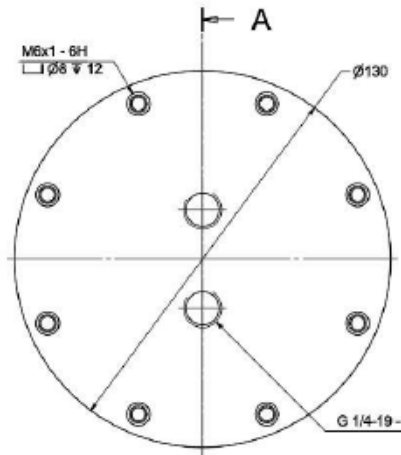

VIEW3 (1:2)

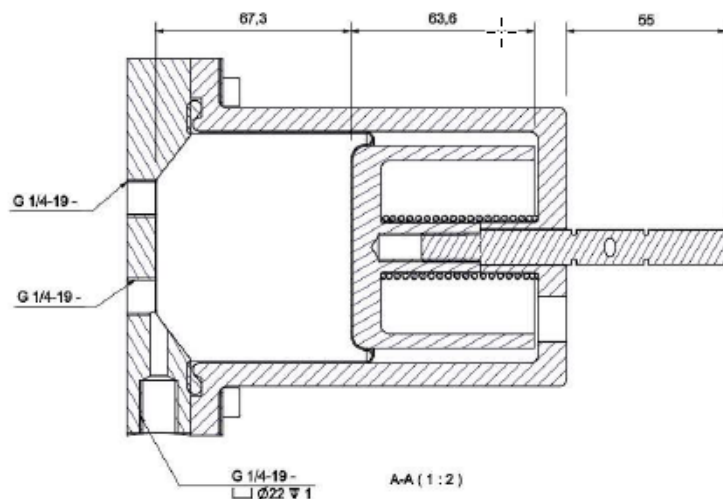

A-A (1:2)

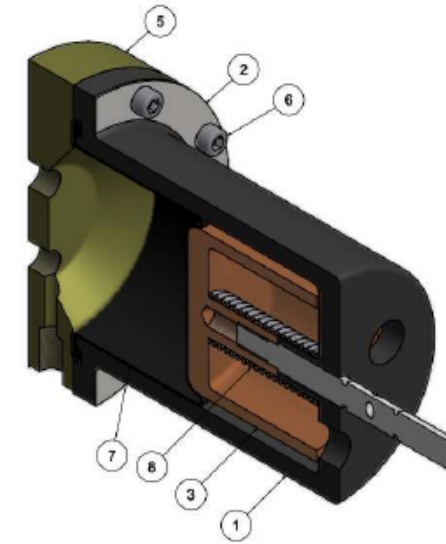

Notes Mechanical Drawing:

1. Fabrication and tolerances shall be according to NS-ISO 2768-1 Medium unless noted otherwise.
2. Max. surface finish Ra=1,6 µm UNO.
3. All sharp edges to be deburred UNO.
4. Dimensions shown is prior to surface treatment.
5. 100% traceability of materials is required in accordance to Materials Certificate 3.1.
6. Surface treatment: NA.

REV.	DATE	REVISION DESCRIPTION	Drw	Eng.	Prj.
01	06.05.09	ISSUED FOR CONSTRUCTION	BAN	AL	BLH
02	12.11.09	RENAMED TO 6710-000	BLH	LKA	AL
03	02.05.11	RENAMED TO IKM STD, PART	BAN	AV	TGA
04	12.04.13	IKM-1003729 removed	SEL	AV	SKH

DOK. NO.	DESCRIPTION
	ROV

IKM
 Subsea AS
This drawing is the property of IKM Subsea, and may not be used, reproduced, published or disclosed in other, without written authorization. www.ikm.no

PROJECT	TOLERANCE PART EXPRESS	PROLTYPE
STANDARD PARTS	NS ISO 2768-1 Med.	

TITLE
 ROV COMPENSATOR SYSTEM 0,25L
 COMPENSATOR BOTTLE 0,25 L
 ASSEMBLY

SIZE	SCALE	PROJECTING	SEC. NO.	REV.	SHEET NO.
A3	1:2	STD	IKM-1003730	04	1 OF 1




Attached Inverter

Dok.ID:	010984	Issue date:	2014.12.29
Approved date:	2015.02.13	Rev.no:	003
Author:	Gabrielsen Trine (Technique)	Owner:	IKM Administrator
Approved by:	Reinsnos Jostein (Technique)	Company:	IKM Technique AS



6231-008 1 Liter Compensator

A-A (1:2)

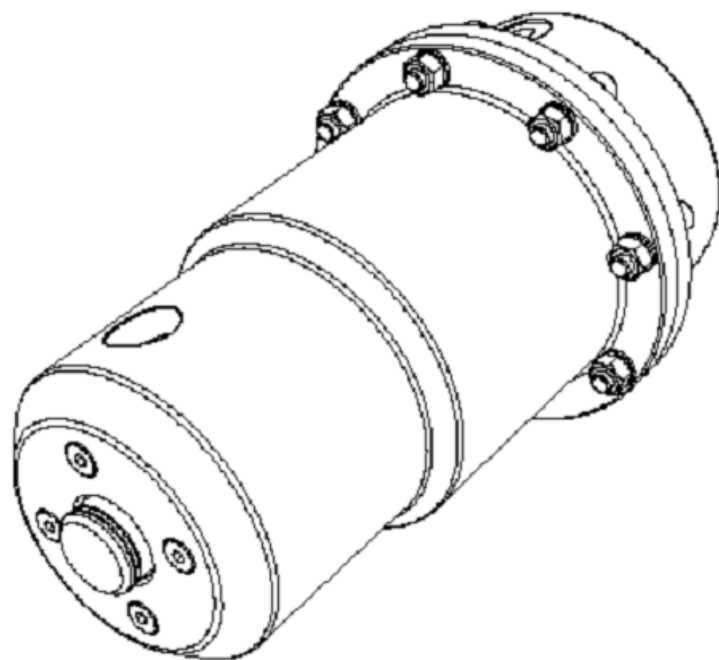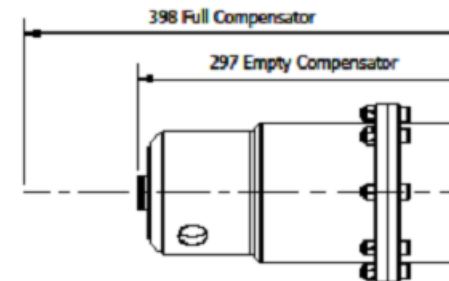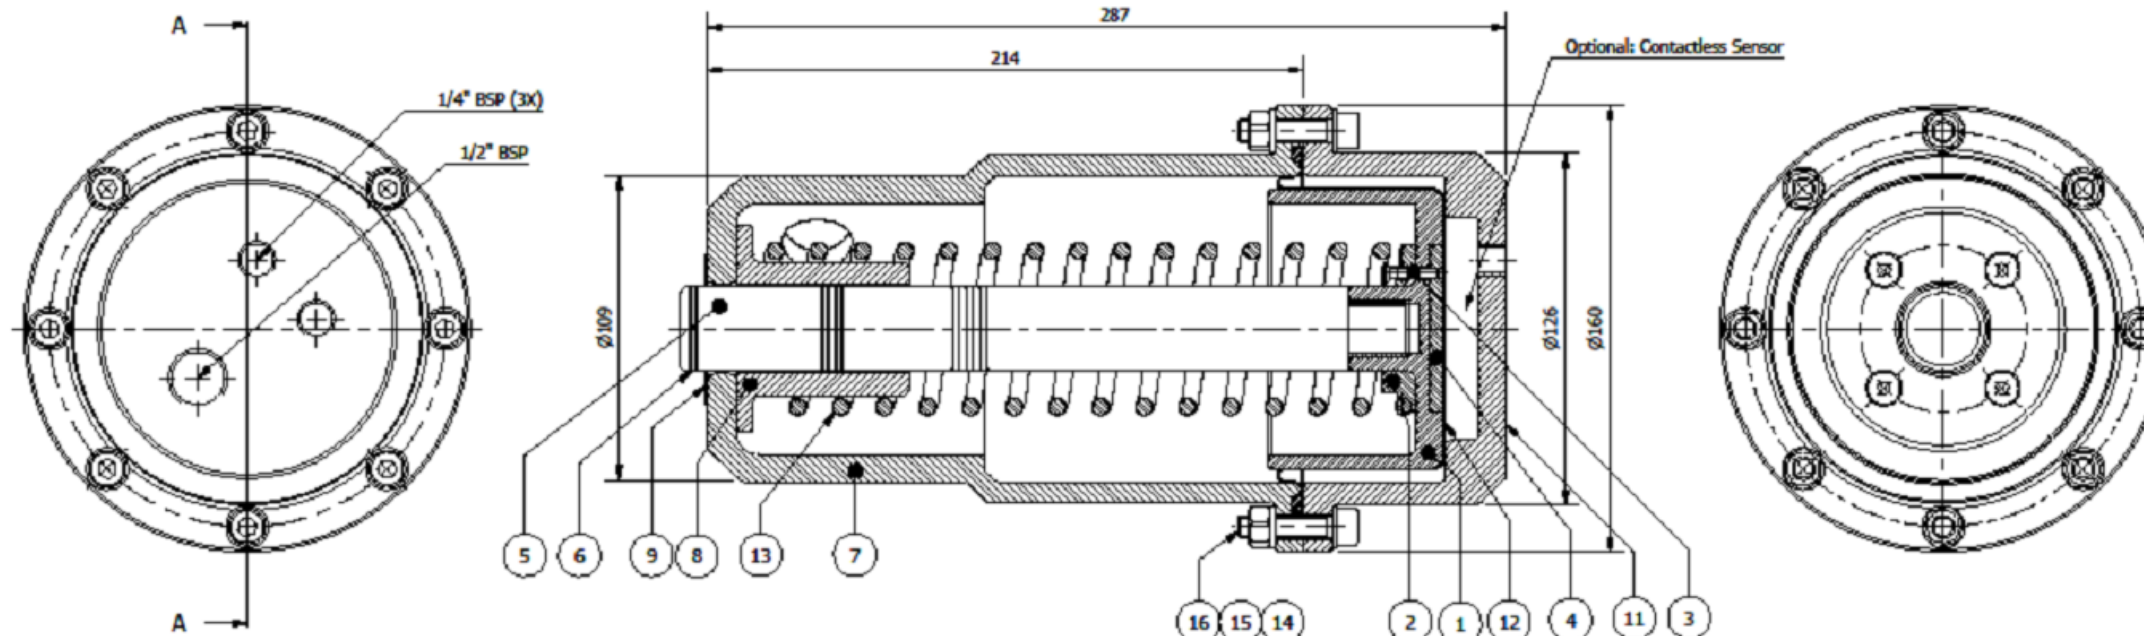

PARTS LIST				
ITEM	QTY	PART NUMBER	MATERIAL	MASS DESCRIPTION
1	1	6231-130	POM	0.22 kg Piston
2	1	6231-128	POM	0.02 kg Guiding
3	3	ISO 10642 - M4 x 20	Stainless Steel	0 kg Screw
4	1	6231-129	Stainless Steel	0.11 kg Sensor plate
5	1	6231-126	POM	0.25 kg Indicator
6	6	ISO 3601-1 - B 0250 G	Rubber	0 kg O-ring
7	1	6231-134	POM	1.03 kg House
8	1	6231-127	POM	0.11 kg Guidrance
9	4	ISO 10642 - M6 x 16	Steel	0 kg Screw
10	1	6231-133	Rubber	0.03 kg Bellows
11	1	6231-131	Aluminium	1.12 kg Cover
12	1	6231-132	Rubber	0.02 kg Bellows
13	1	6231-135	Stainless Steel	0.6 kg Coil spring
14	16	ISO 7092 - ST 8 - 140 HV	Stainless Steel	0 kg Washer
15	8	ISO 4034 - M8	Steel, Mild	0.01 kg Nut
16	8	ISO 4762 - M8 x 35	Stainless Steel	0.02 kg Screw





02	2013-01-29	As Built	POD	ICG	POD
01	10.10.2012	For Construction	POD	ICG	POD
REV	DATE	DESCRIPTION	BY	CHKD	APPR
WEIGHT					
IN AIR	3,74 kg				
IN WATER	2,03 kg				
TOLERANCES UNLESS OTHERWISE SPECIFIED:					
ALL DIMENSIONS ARE IN MILLIMETRES					
TOLERANCES:					
LINEAR: ISO 2768-1					
ANGULAR: ISO 2768-1					
EDGES: ISO 2768-1					
REMOVE ALL BURRS BREAK ALL SHARP EDGES					
FIRST ANGLE PROJECTOR					
SHEET SIZE: A3	SHEET NO: 1 OF 1	SCALE:			
DRAWING NO: 6231-008		LATEST REV: 02			


IKM TECHNIQUE AS
 Tomroseveien 12, 4315 SANDNES
 Tel.: 51 80 05 20
 E-mail: ikmtechnique@ikm.no
 Web: www.ikm.no

THIS DOCUMENT CONTAINS PROPRIETARY INFORMATION WHICH IS THE PROPERTY OF IKM TECHNIQUE AS. NONE OF THE INFORMATION CONTAINED HEREIN MAY BE DISCLOSED, REPRODUCED, DISTRIBUTED OR USED WITHOUT WRITTEN CONSENT FROM IKM TECHNIQUE AS.

PROJECT TITLE: P6231
 DRAWING TITLE: COMPENSATOR 1.0 L - GA

6231-003 2 Liter Compensator (1)

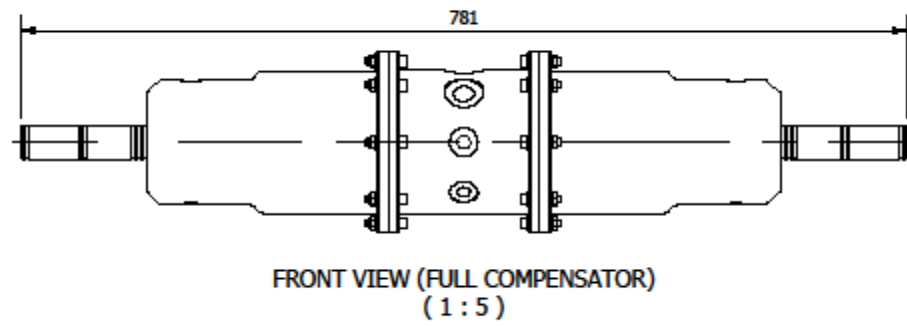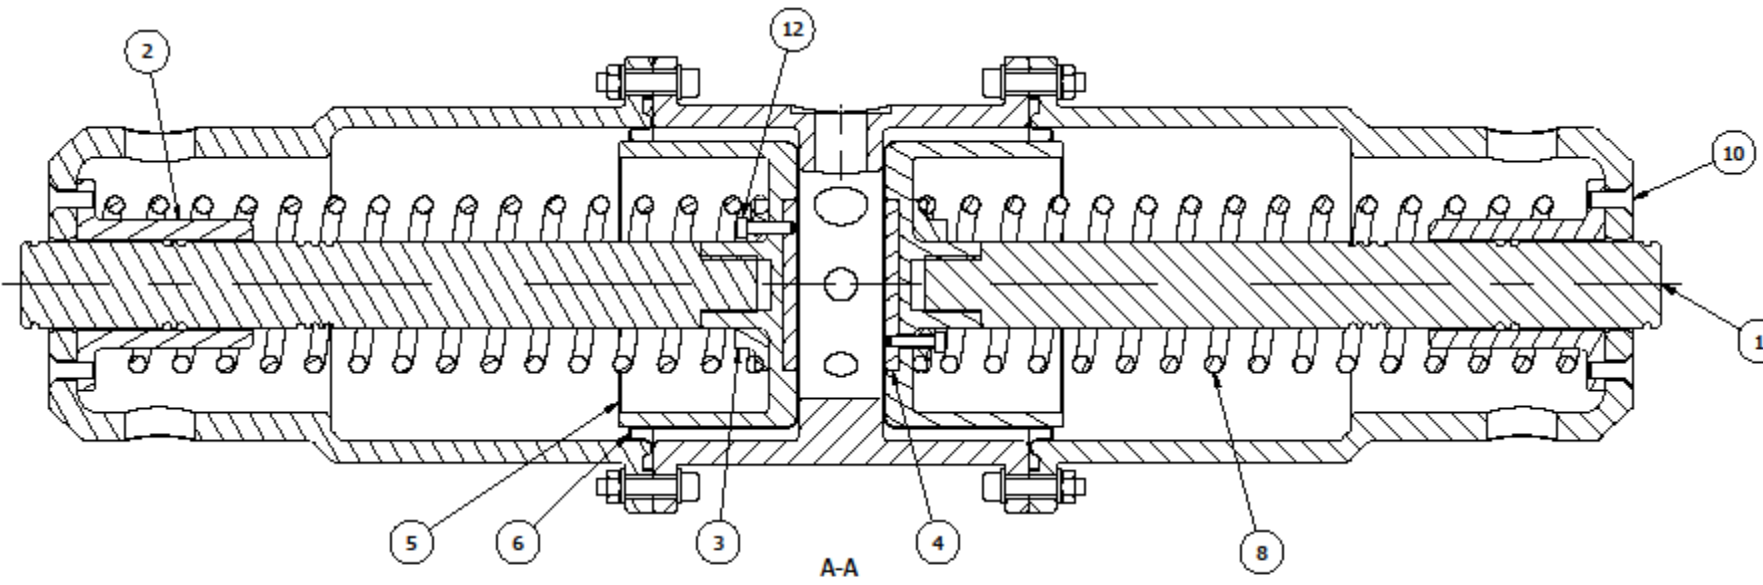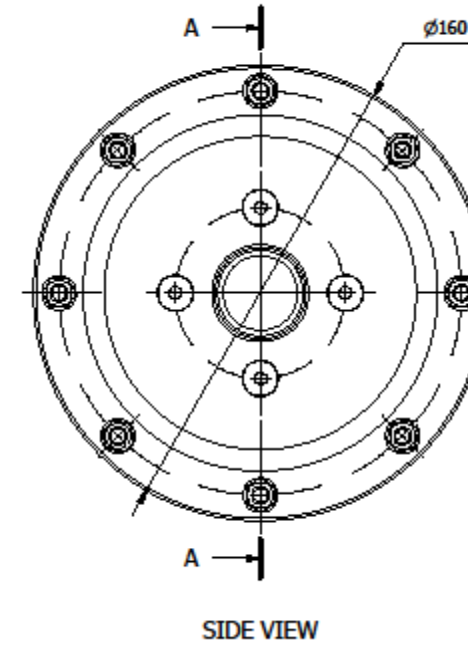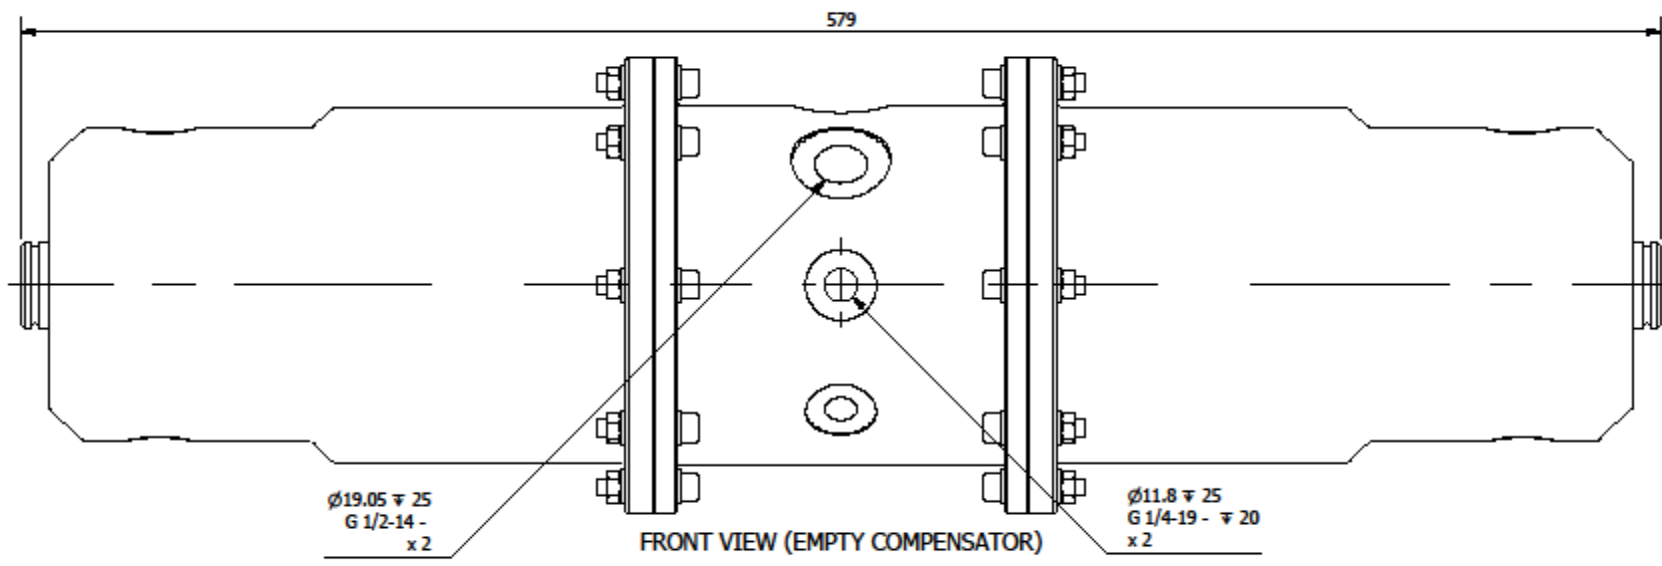


01	02.03.2015	FOR CONSTRUCTION	JJK	RH	JJK
REV	DATE	DESCRIPTION	BY	CHKD	APPR
WEIGHT:		 IKM TECHNIQUE AS Tomroseveien 12, 4315 SANDNES Tel.: 51 80 05 20 E-mail: ikmtechnique@IKM.no Web: www.IKM.no	THIS DOCUMENT CONTAINS PROPRIETARY INFORMATION WHICH IS THE PROPERTY OF IKM TECHNIQUE AS. NONE OF THE INFORMATION CONTAINED HEREIN MAY BE DISCLOSED, REPRODUCED, DISTRIBUTED OR USED WITHOUT WRITTEN CONSENT FROM IKM TECHNIQUE AS.		
IN AIR: 6,62 kg			PROJECT TITLE:		
IN WATER: 3,48 kg		P6231			
SURFACE AREA: 1011 cm ²		DRAWING TITLE: COMPENSATOR 2,0 L			
UNLESS OTHERWISE SPECIFIED ALL DIMENSIONS ARE IN MILLIMETRES		SHEET SIZE: A3			
TOLERANCES:		SHEET NO.: 1 OF 2			
LINEAR: ISO 2768-1 C		SCALE: 1:2			
ANGULAR: ISO 2768-1 C		DRAWING NO.: 6231-003			
EDGES: ISO 2768-1 C		LATEST REV.: 01			
REMOVE ALL BURRS					
BREAK ALL SHARP EDGES					
FIRST ANGLE PROJECTION					

6231-003 2 Liter Compensator (2)




SECTIONED ISO VIEW (EMPTY COMPENSATOR)



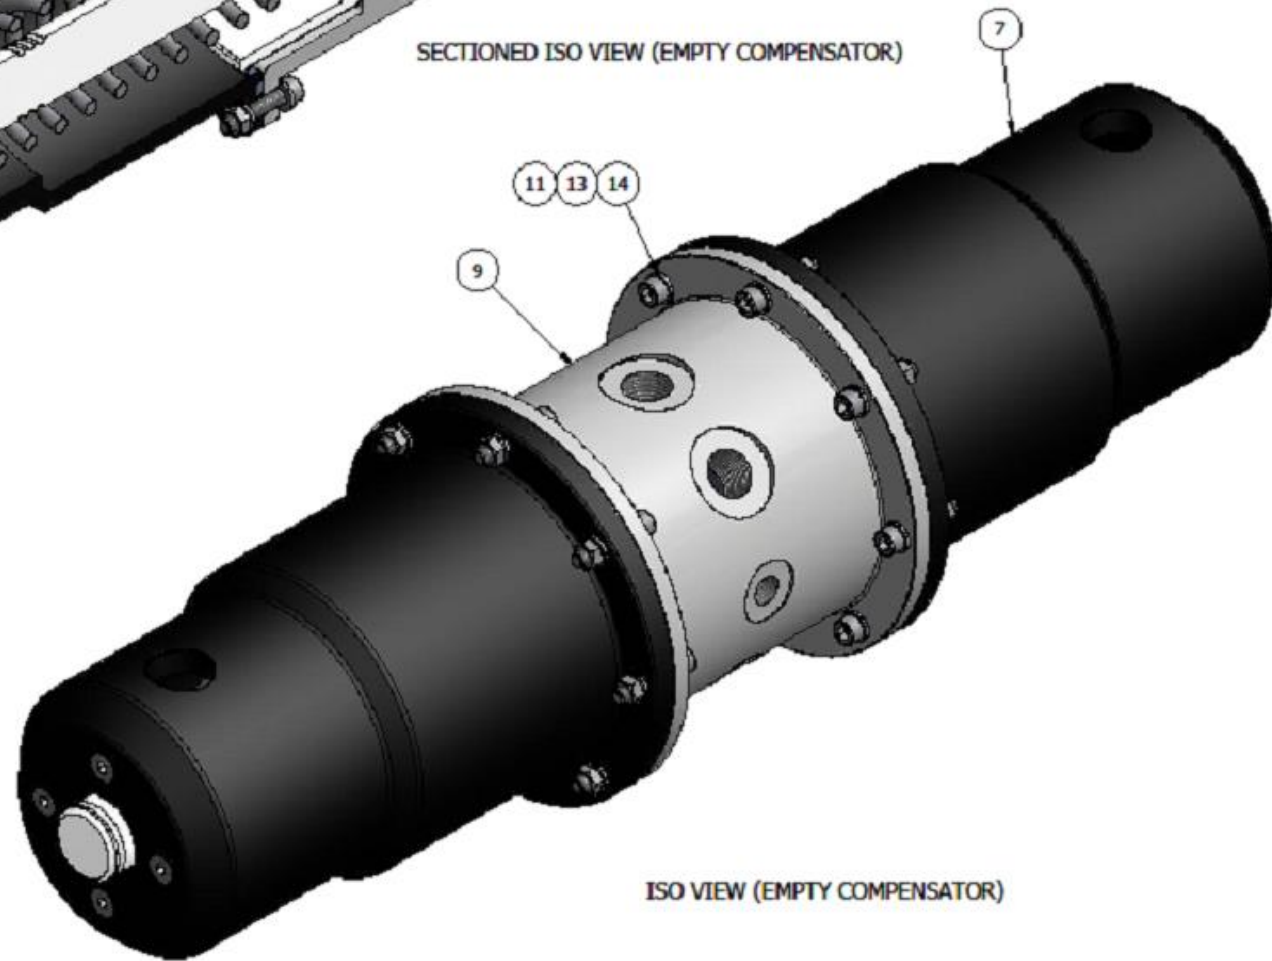


ISO VIEW (EMPTY COMPENSATOR)

PARTS LIST						
ITEM	QTY	PART NUMBER	MATERIAL	DESCRIPTION	MASS	REV
1	2	6231-126	POM-H (natural / white)	Indicator	0.25 kg	01
2	2	6231-127	POM-H (black)	Guidance	0.09 kg	02
3	2	6231-128	POM-H (natural / white)	Guiding	0.02 kg	02
4	2	6231-129	Stainless Steel, S165M	Sensor plate	0.11 kg	01
5	2	6231-130	POM-C (natural / white)	Piston	0.22 kg	01
6	2	6231-132	AS SUPPLIED	DIAPHRAGM BFA 110/100-65 SONBR/253	0.02 kg	01
7	2	6231-134	POM-H (black)	House	1.03 kg	01
8	2	6231-135	Stainless Spring Steel, EN 10270-3-1.4310	Coil spring	0.6 kg	01
9	1	6231-201	Aluminium, 6082-T6	HOUSING	1.67 kg	01
10	8	DIN 7991 - M6x16	Stainless Steel	Hexagon socket countersunk head cap screws	0 kg	
11	16	ISO 4032 - M6	Stainless Steel	Hexagon nuts, style 1 - Product: grades A and B	0 kg	
12	6	ISO 4762 - M4 x 16	Stainless Steel	Hexagon Socket Head Cap Screw	0 kg	
13	16	ISO 4762 - M6 x 30	Stainless Steel	Hexagon Socket Head Cap Screw	0.01 kg	
14	32	ISO 7089 - 6 - 140 HV	Stainless Steel	Plain washers - Normal series - Product grade A	0 kg	


REV	DATE	DESCRIPTION	BY	CHKD	APPD
01	02.03.2015	FOR CONSTRUCTION	JJK	RH	JJK
WEIGHT:		 IKM TECHNIQUE AS Tomeroseveien 12, 4315 SANDNES Tel: 51 80 05 20 E-mail: ikmtechnique@ikm.no Web: www.ikm.no	THIS DOCUMENT CONTAINS PROPRIETARY INFORMATION WHICH IS THE PROPERTY OF IKM TECHNIQUE AS. NONE OF THE INFORMATION CONTAINED HEREIN MAY BE DISCLOSED, REPRODUCED, DISTRIBUTED OR USED WITHOUT WRITTEN CONSENT FROM IKM TECHNIQUE AS.		
IN AIR	6,62 kg		PROJECT TITLE: P6231 DRAWING TITLE: COMPENSATOR 2,0 L		
IN WATER	3,48 kg				
SURFACE AREA:					
	1011 cm ²				
UNLESS OTHERWISE SPECIFIED: ALL DIMENSIONS ARE IN MILLIMETRES TOLERANCES: LINEAR: ISO 2768-1 C ANGULAR: ISO 2768-1 C EDGES: ISO 2768-1 C REMOVE ALL BURRS BREAK ALL SHARP EDGES					
FIRST ANGLE PROJECTION		SHEET SIZE: A3		SHEET NO: 2 OF 2	
		DRAWING NO: 6231-003		SCALE: 1:2	
				LATEST REV: 01	

6231-000 3 Liter Compensator

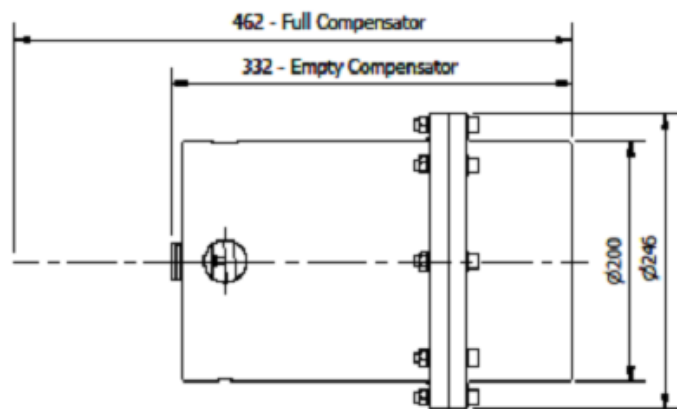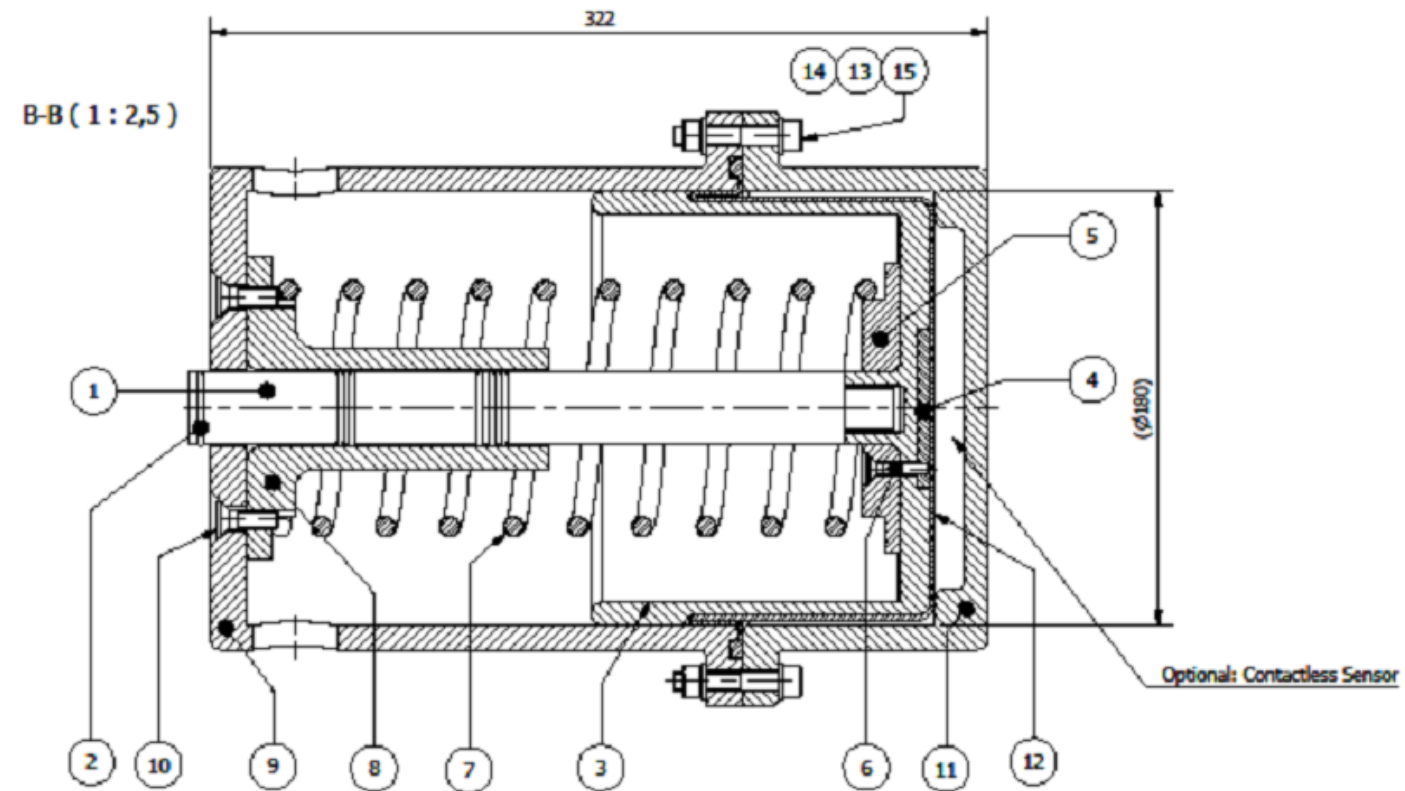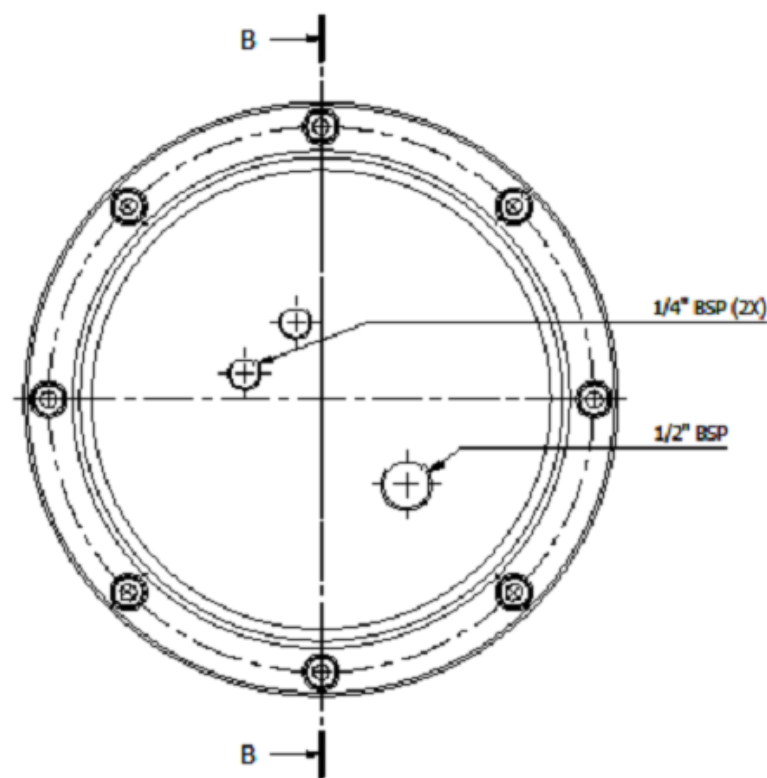

PARTS LIST					
ITEM	QTY	PART NUMBER	MATERIAL	MASS	DESCRIPTION
1	1	6231-137	POM-C (natural / white)	0.28 kg	Indicator
2	6	ISO 3601-1 - B 0258 G	Rubber	0 kg	O-ring
3	1	6231-109	POM-C (black)	1.01 kg	Guiding Tube
4	1	6231-125	Stainless Steel, S165M	0.13 kg	Sensor plate
5	1	6231-107	POM-C (natural / white)	0.17 kg	Guide
6	3	ISO 10642 - M5 x 25	Stainless	0 kg	Screw
7	1	6231-112	Stainless Spring Steel, EN 10270-3-1.4310	1.23 kg	Coil Spring
8	1	6231-108	POM-C (black)	0.41 kg	Guiding Tube
9	1	6231-111	POM-C (black)	2.51 kg	Bottle 3L
10	4	ISO 10642 - M8 x 25	Stainless	0.01 kg	Screw
11	1	6231-123	Aluminium, 6082-T6	3.19 kg	Cover
12	1	6231-115	Rubber	0.19 kg	Bellow Art. no: 3844024
13	16	ISO 7092 - ST 8 - 140 HV	Stainless Steel	0 kg	Washer
14	8	ISO 4034 - M8	Stainless	0.01 kg	Nut
15	8	ISO 4762 - M8 x 45	Stainless Steel, 440C	0.02 kg	Screw

REV	DATE	DESCRIPTION	POD	EN	POD
01	2013-01-25	As Built	BY	CHKD	APPD
WEIGHT:					
IN AIR		9,44 kg			
IN WATER		4,74 kg			
UNLESS OTHERWISE SPECIFIED					
ALL DIMENSIONS ARE IN MILLIMETRES					
TOLERANCES:					
LINEAR: ISO 2768-1 m					
ANGULAR: ISO 2768-1 m					
EDGES: ISO 2768-1 m					
REMOVE ALL BURRS					
BREAK ALL SHARP EDGES					
FIRST ANGLE PROJECTION					
SHEET SIZE:		A3	SHEET NO.:		1 OF 1
DRAWING NO.:		6231-000	SCALE:		
			LATEST REV.:		01



IKM TECHNIQUE AS
 Tomeroseveien 12, 4315 SANDNES
 Tel.: 51 80 05 20
 E-mail: ikmtechnique@ikm.no
 Web: www.ikm.no

THIS DOCUMENT CONTAINS PROPRIETARY INFORMATION WHICH IS THE PROPERTY OF IKM TECHNIQUE AS. NONE OF THE INFORMATION CONTAINED HEREIN MAY BE DISCLOSED, REPRODUCED, DISTRIBUTED OR USED WITHOUT WRITTEN CONSENT FROM IKM TECHNIQUE AS.

PROJECT TITLE: P6231
 DRAWING TITLE: COMPENSATOR 3.0 L - GA

